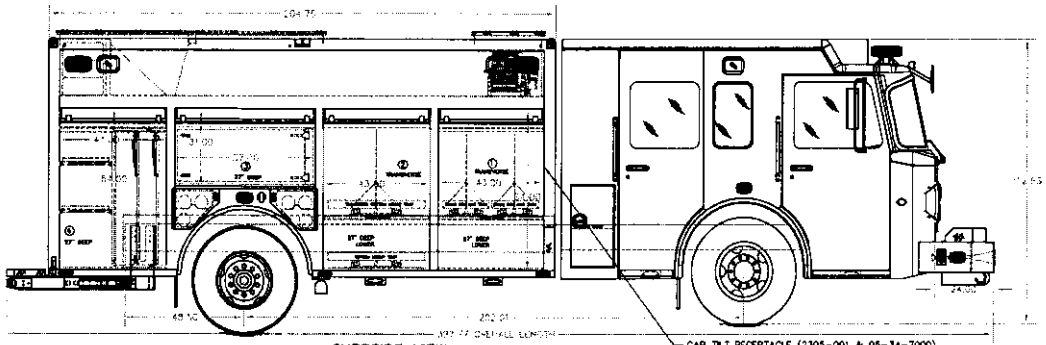

CURBSIDE VIEW

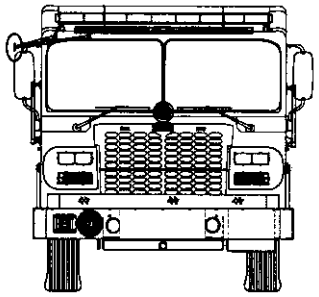

FRONT VIEW

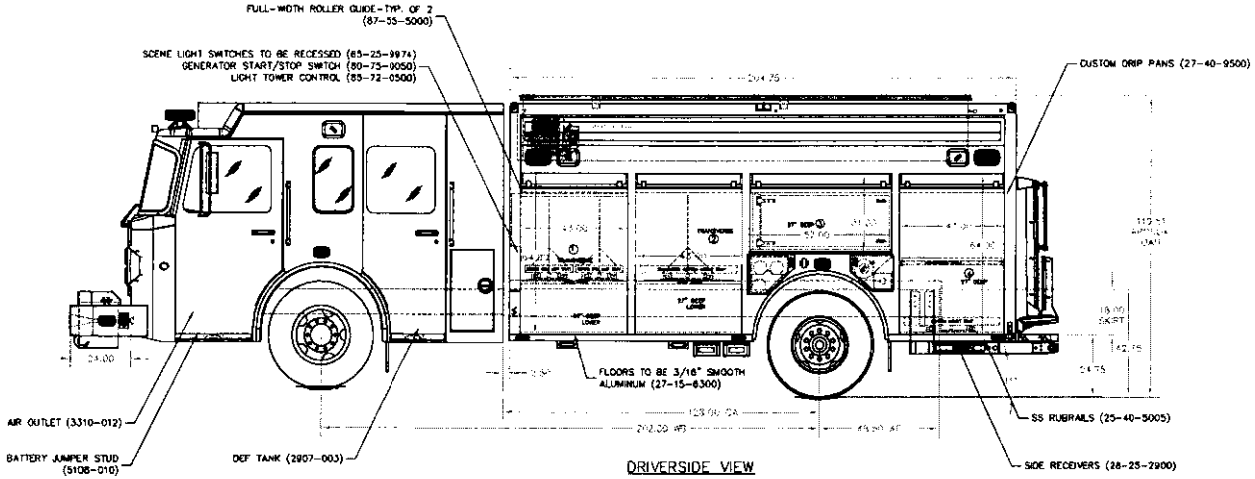

DRIVERSIDE VIEW

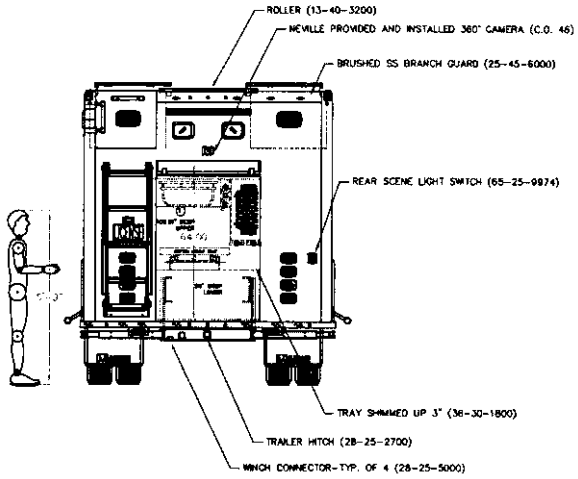

REAR VIEW

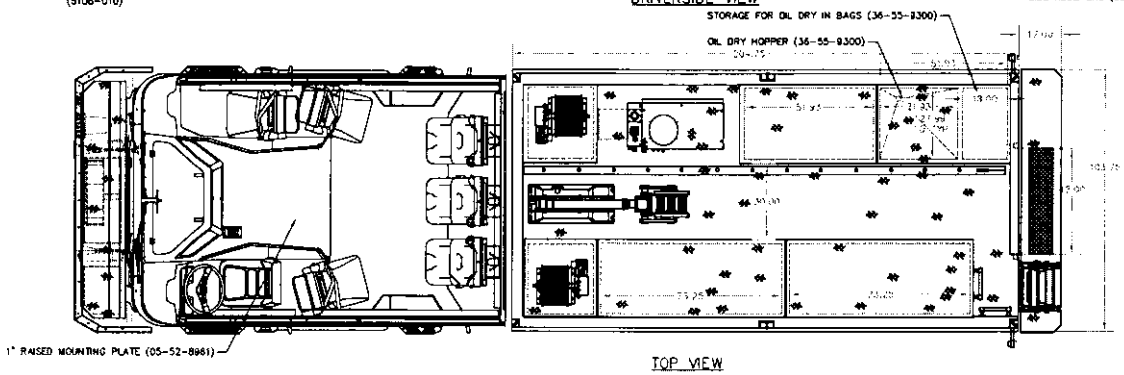

TOP VIEW

NO MAXIMUM OVERALL LENGTH SPECIFIED (33-48-1000)
MAXIMUM OVERALL HEIGHT 9'-6.5" OR 114.5" (33-48-2000)

PRINT APPROVAL
I HAVE EXAMINED THIS DOCUMENT AND APPROVED WITH NOTED REVISIONS, IF ANY, IN RED.
9/19

97876 MBW JOB NUMBER

C	8/30/24	GRS	REV PER CHANGE ORDERS 43-64
B	3/13/24	GRS	REV PER PRE-CON. MARKED-UP DWG (REAR COMPT. & TRAY)
A	1/23/24	GRS	REVISED PER CHANGE ORDERS 1-42

CHASSIS SPEC'S: SPARTAN GLADIATOR 6PD 202" 128"

MARION

TITLE: 17' RESCUE VEHICLE
FOR: HUNTINGTON MANOR, NY
DWN: GRS DATE: 11/20/23 SCALE: 1/20
DWG NO: 98301249 SHEET: 1 OF 1